




FIELD VERIFY. THE FAA IS UNAWARE IF THE ROOF SYSTEM HAS BEEN REPLACED AFTER THIS AS-BUILTS WERE CREATED BY THE PREVIOUS OWNER.

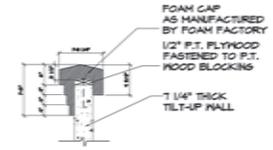

2 FOAM GAP DETAIL
A1.5 NOT TO SCALE

• FACTORY MUTUAL APPROVED.
• UNITS ARE DESIGNED FOR DOWNS TO DROP OUT IN LESS THAN 5 MINUTES AT 500° F WHEN SUBJECTED TO THE STANDARD FM FIRE EXPOSURE TEST.

STOCK NUMBER	INSIDE CURB DIMENSIONS	QTY.
SL-00-FW 5555	48 X 48	
SL-00-FW 5566	48 X 60	
SL-00-FW 5578	48 X 72	
SL-00-FW 5596	48 X 90	
SL-00-FW 55102	48 X 96	

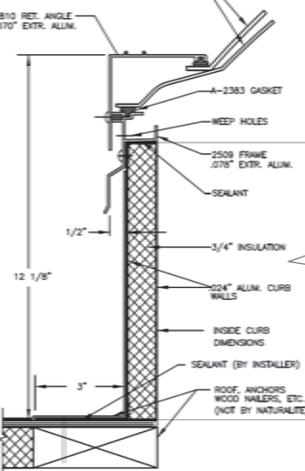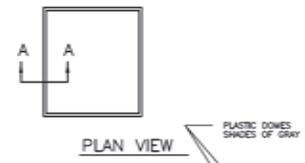

SECTION A-A
HALF SCALE

STEPHENS ARCHITECTURAL ASSOCIATES, INC.
Architecture / Planning
Building, Functional
Innovative Architecture
www.DesignAndBuild.com

MEMPHIS OFFICE: 901.525.3700
BIRMINGHAM OFFICE: 205.978.1100
NASHVILLE OFFICE: 615.252.1100
MEMPHIS OFFICE: 901.525.3700
BIRMINGHAM OFFICE: 205.978.1100
NASHVILLE OFFICE: 615.252.1100

STEPHENS ARCHITECTURAL ASSOCIATES, INC. 2008
The drawings are the property of Stephens Architectural Associates, Inc. and are not to be reproduced, copied, or used in whole or in part without the written consent of Stephens Architectural Associates, Inc.

ATHENA CONTROLS
VINT HILL, WARRENTON, VA
ZUMOT REAL ESTATE MANAGEMENT

NO.	DATE	BY	REVISION
1	04-21-08	RAG	REV. SET
2	05-02-08	RAG	FINAL PERMIT SET
3	02-05-09	RAG	REV. PERMIT SET
4	02-08-09	RAG	PERMIT SET
5	04-07-09	RAG	REVISION
2	08-02-09	RAG	REVISED PERMITS
1	01-05-09	RAG	PRELIMINARY

DATE: 08/05/09
SHEET STATUS

NO.	DATE	BY	REVISION
1	04-21-08	RAG	REV. SET
2	05-02-08	RAG	FINAL PERMIT SET
3	02-05-09	RAG	REV. PERMIT SET
4	02-08-09	RAG	PERMIT SET
5	04-07-09	RAG	REVISION
2	08-02-09	RAG	REVISED PERMITS
1	01-05-09	RAG	PRELIMINARY

DATE: 08/05/09
SHEET STATUS

ROOF PLAN

DRAWN BY: RWF
CHK'D BY: RAG
JOB NO. 08085
SHEET NO. A1.5

1 ROOF PLAN
A1.5 1/8" = 1'-0"

TPO= THERMOPLASTIC POLYOLEFIN

