NOTES

1. AFTER PLUMBING WORK HAS BEEN COMPLETED, REPAIR CONCRETE SLAB TO A SMOOTH FINISH.

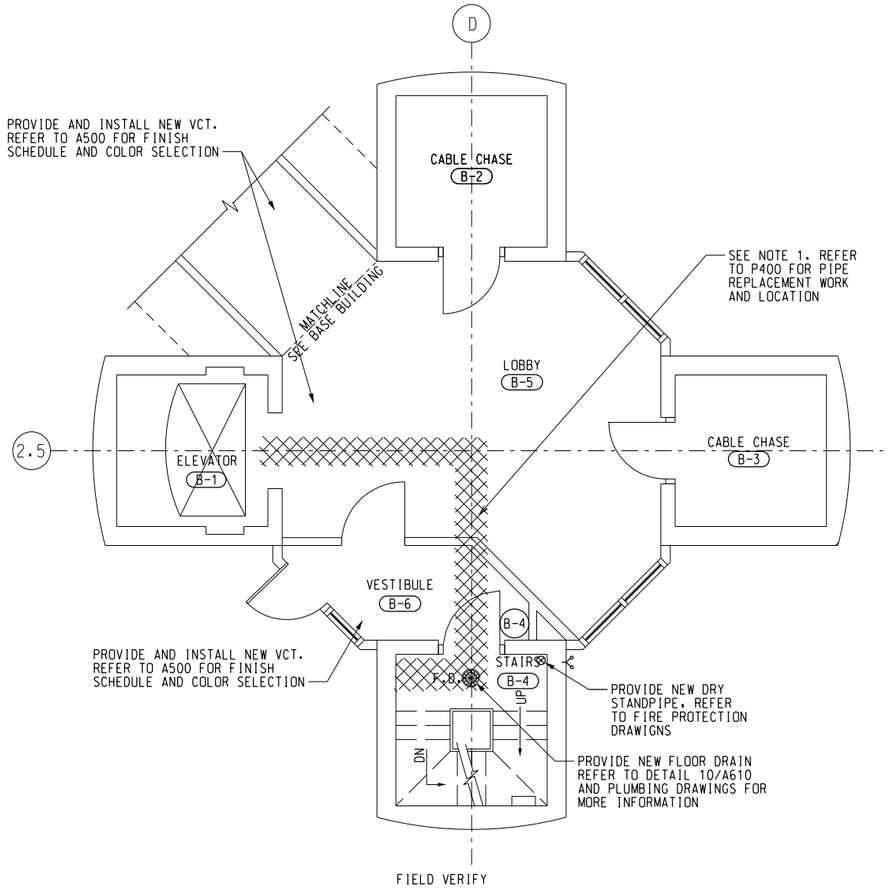

1 A100 GROUND LEVEL FLOOR PLAN

SCALE: 1/4" = 1' - 0"

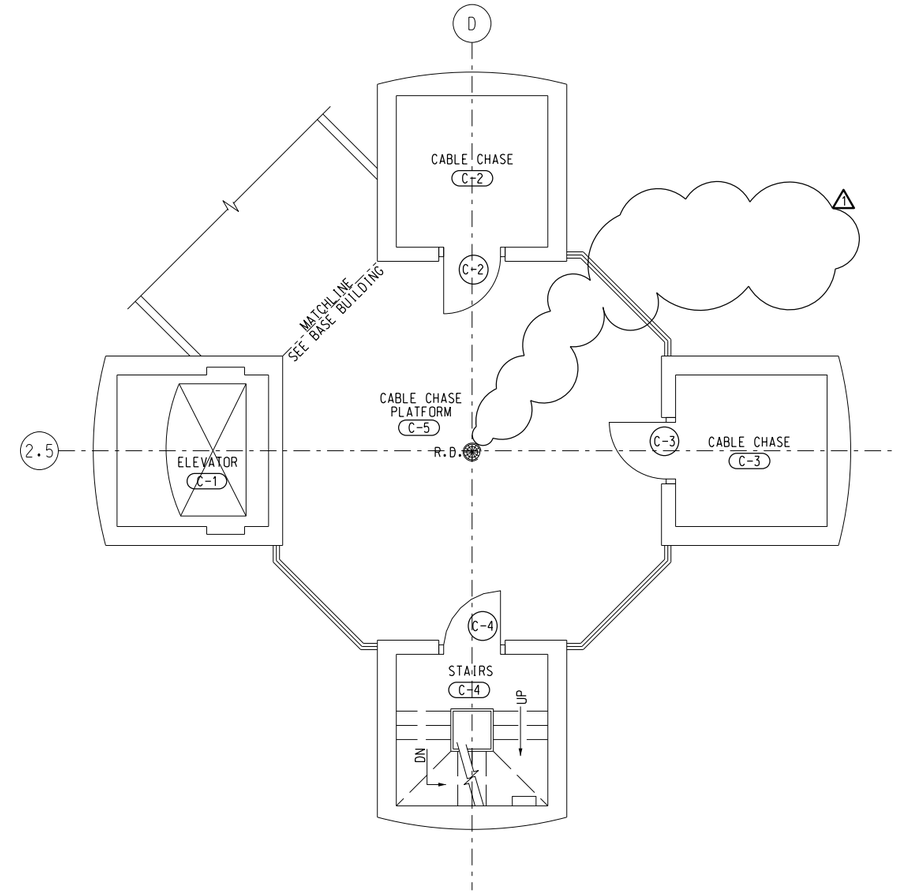

2 A100 SECOND LEVEL FLOOR PLAN

SCALE: 1/4" = 1' - 0"

NO WORK TO BE DONE IN THIS LEVEL

N

4' 0 4' 8'

1/4" = 1'-0"

SCALES SHOWN FOR 22" X 34" SHEET. ADJUST SCALES FOR OTHER SIZES.

PAGE OF

REV	APPROVED DATE	DESCRIPTION	JCN	REDLINE DATE	APVD
1	08/05/2020	ISSUE FOR CONSTRUCTION			

DEPARTMENT OF TRANSPORTATION
FEDERAL AVIATION ADMINISTRATION

FORT LAUDERDALE AIRPORT TRAFFIC CONTROL TOWER
MAJOR IMPROVEMENTS
ARCHITECTURAL
GROUND AND SECOND FLOOR PLAN

FT LAUDERDALE (INTERNATIONAL) FL

Wiley|Wilson
5901 Peachtree Dunwoody Rd.
Bldg. C, Ste 515
Atlanta, Georgia 30328-6055
678.320.1888
wileywilson.com

WW JOB NUMBER: 219075.00

REVIEWED BY | SUBMITTED BY | APPROVED BY

SUBMITTER'S TITLE - CIVIL ENGINEER | APPROVER'S TITLE - MANAGER

DESIGNED GMR | DRAWN GMR | CHECKED NXE

ISSUED BY: ATLANTA TERMINAL ENGINEERING CENTER

DATE JAN 31, 2020 | JCN 1508912

DRAWING NO FLL-D-ATCT-A100 | REV 1