FAA PROVIDED: FOR INFORMATION ONLY

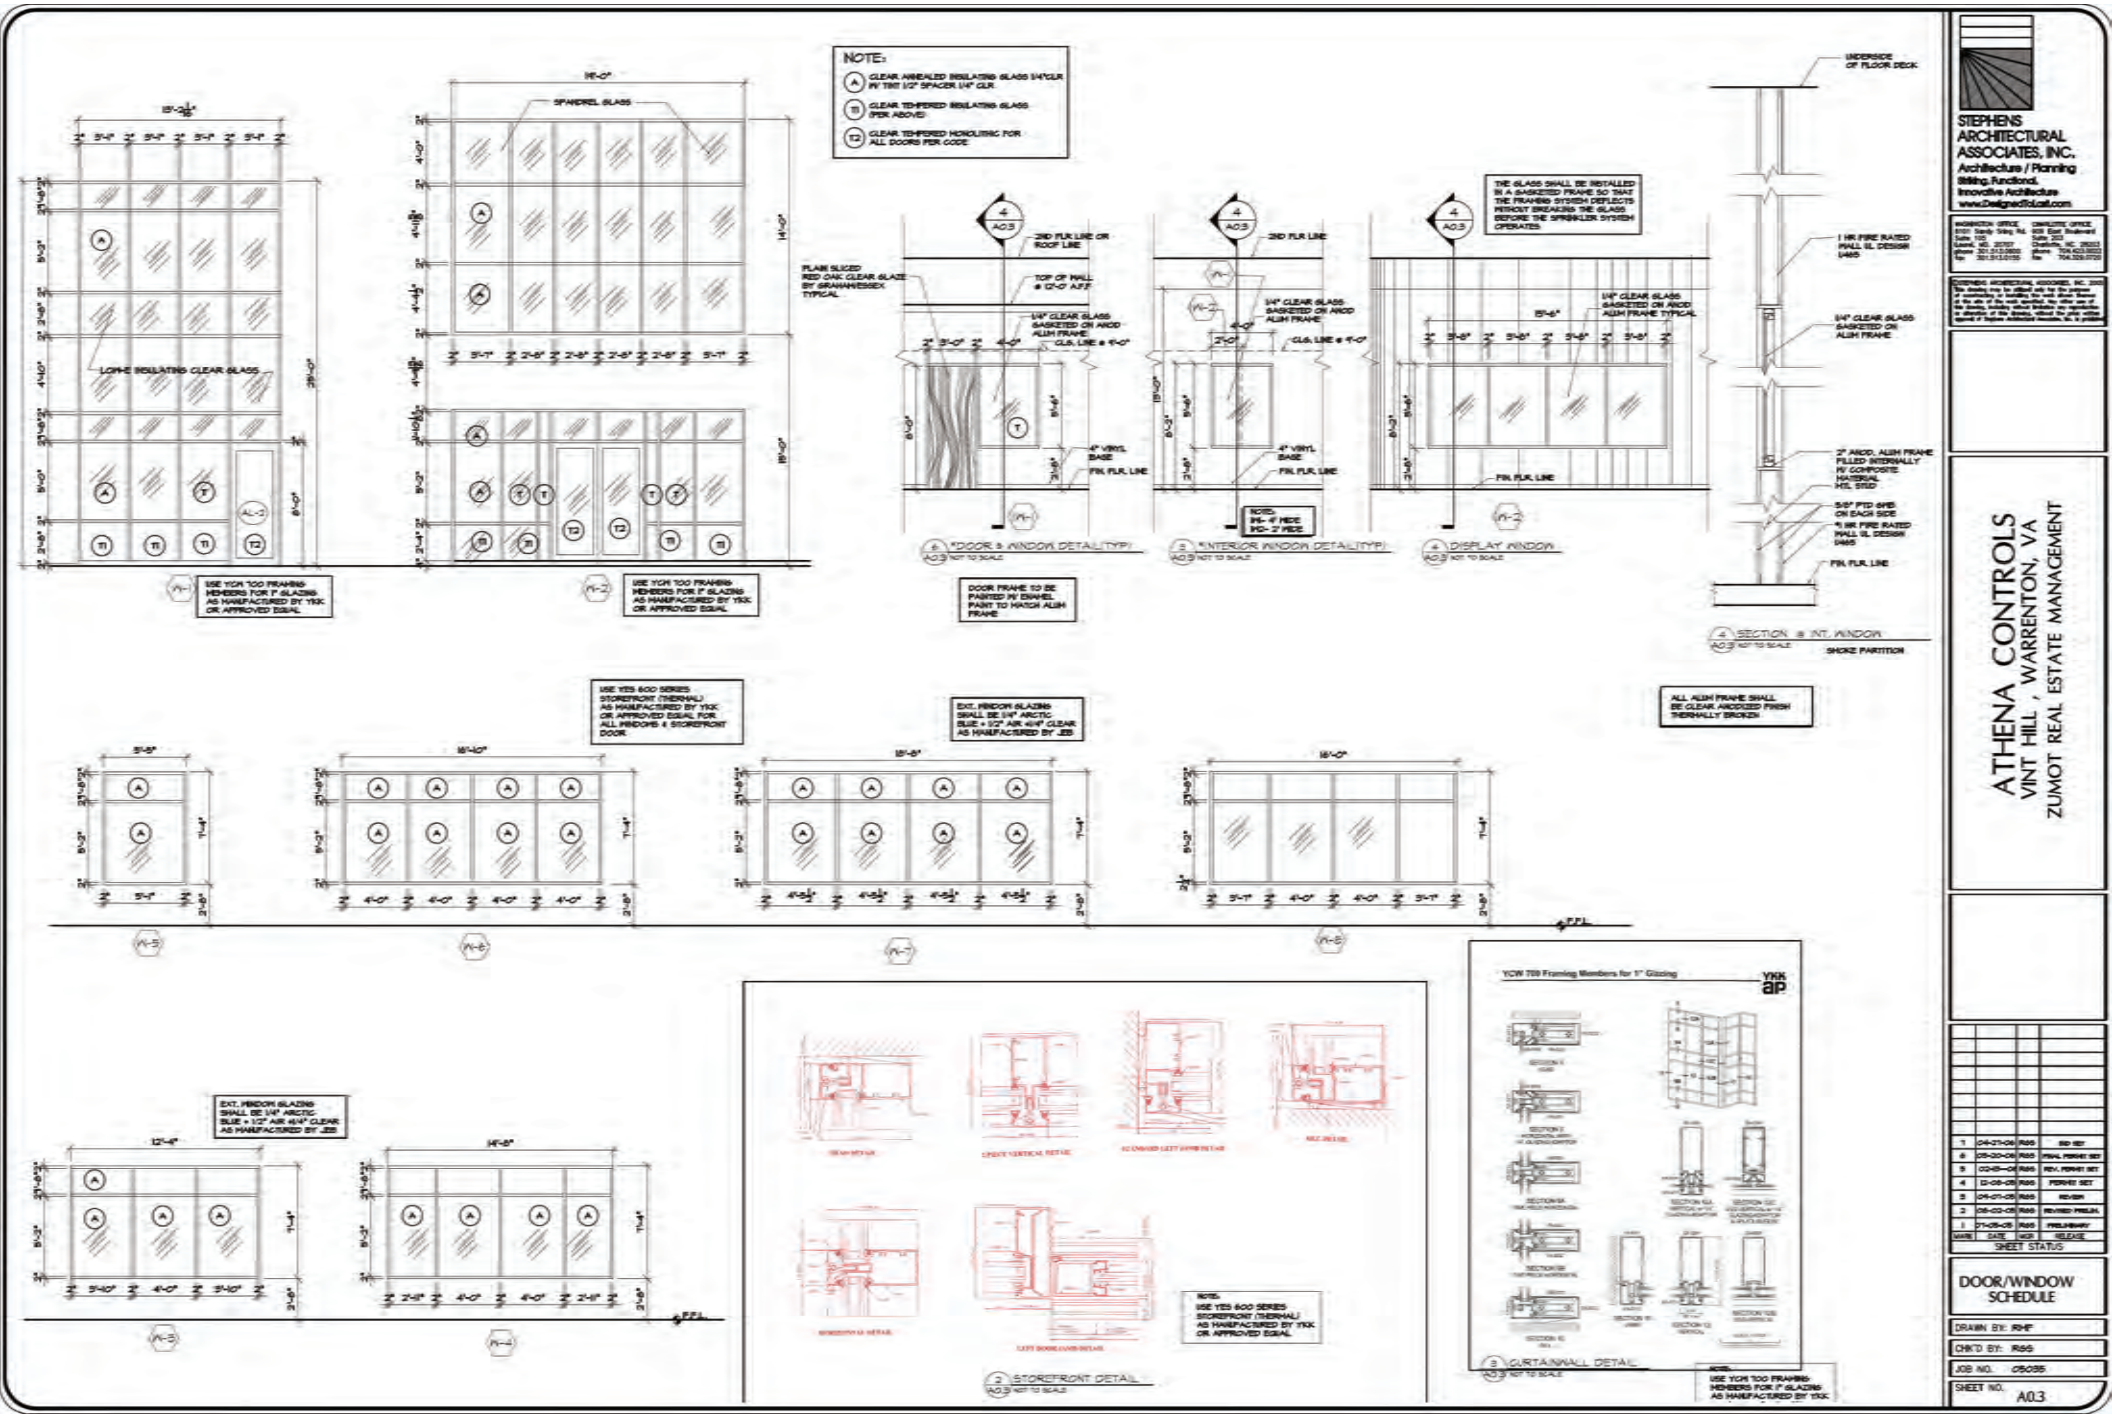

STEPHENS ARCHITECTURAL ASSOCIATES, INC.
Architecture / Planning
Sitting, Functional, Innovative Architecture
www.DesignedToLast.com

ATHENA CONTROLS
VINT HILL , WARRENTON, VA
ZUMOT REAL ESTATE MANAGEMENT

MARK	DATE	WHO	RELEASE
1	04-21-06	RMS	BID SET
6	05-30-06	RMS	FINAL PERMIT SET
5	03-08-06	RMS	REV. PERMIT SET
4	12-05-05	RMS	PERMIT SET
3	04-07-05	RMS	REVISION
2	08-02-05	RMS	REVISED PRELIM.
1	21-05-05	RMS	PRELIMINARY

SHEET STATUS

DOOR/WINDOW SCHEDULE

DRAWN BY: RMS
CHK'D BY: RMS
JOB NO. 05035
SHEET NO. A0.3